


PLAN SHOWING DIMENSIONS



AS-BUILT PLANS

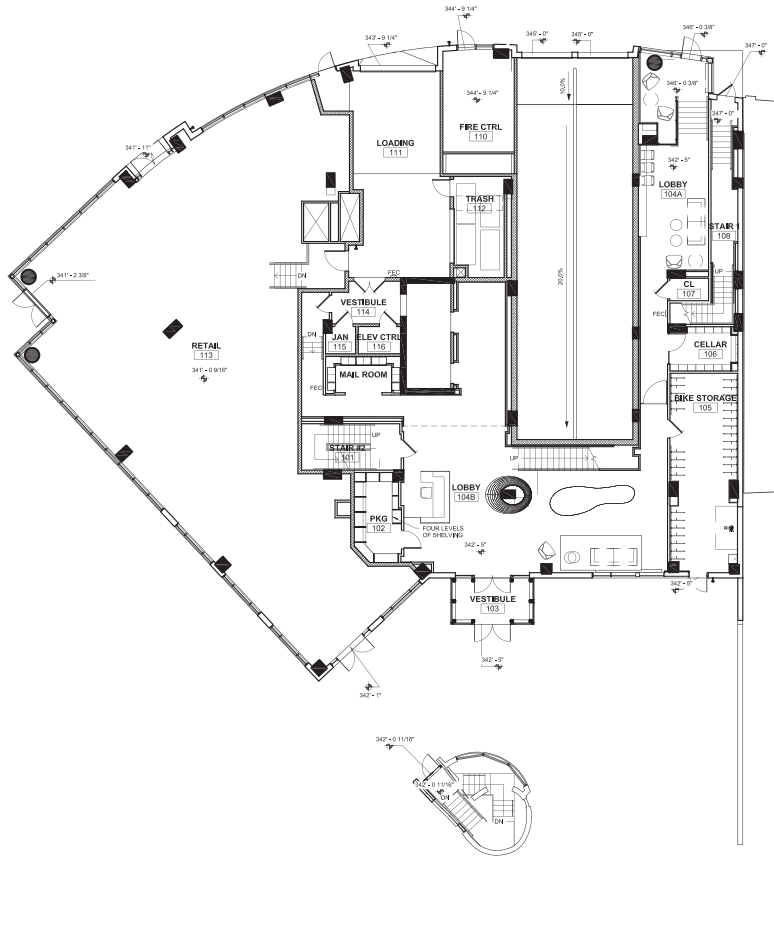